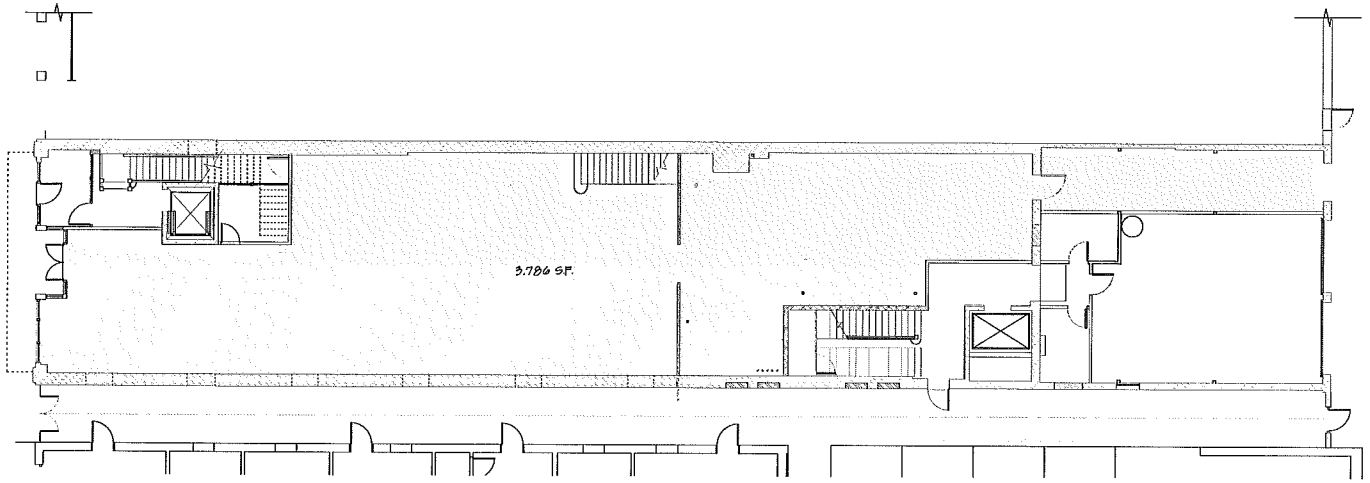

1 / A-1.01 FIRST LEVEL PLAN
SCALE: 1/8" = 1'-0"

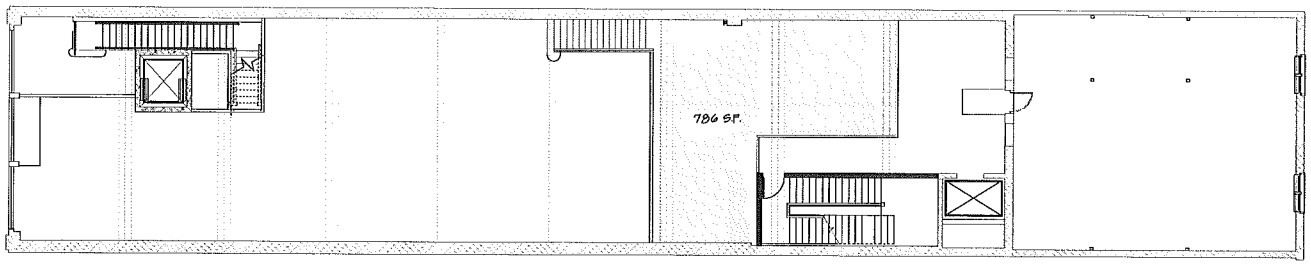

2 / A-1.01 MEZZANINE LEVEL PLAN
SCALE: 1/8" = 1'-0"

Copyright 2008 - Cheatham-Fletcher-Scott Architects

CHEATHAM•LETCHER•SCOTT, ARCHITECTS, P.C.
Architecture • Planning • Interior Design
420 1/2 Eighth Street
Augusta, GA 30901
Phone: (706) 724-2668 Fax: (706) 849-9919

GREEN BUILDING

1019 Broad Street
Augusta, Georgia

RECORD DRAWING

NO.	DATE	REVISION SUBMITTAL
01	11-24-08	REVISED

Seal

Seal

FIRST FLOOR and MEZZANINE PLAN

Scale: 1/8" = 1'-0"
Job No.:
Drawn by: RF/HH
Date: 11/21/08

A-1.01